

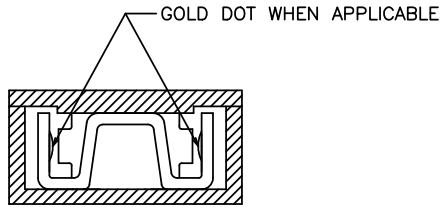
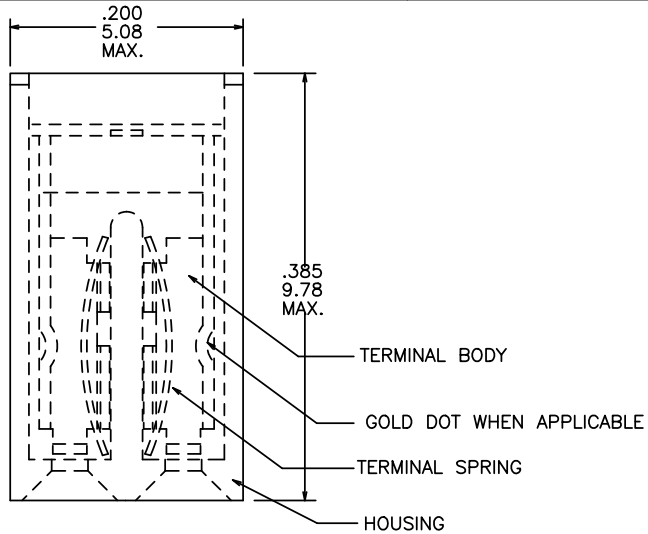
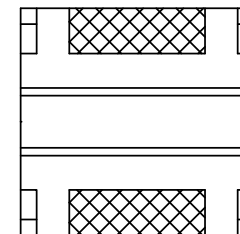


PRODUCT NO	TERMINAL BODY		LEAD FREE
	MATERIAL	PLATING OR GOLD DOT	OPTION
<del>65829-001</del>	<del>0.25/.010 THK 1/4 HD CU NI ALLOY UNS C72500</del>	<del>.002/.001 MIN THK GOLD DOT</del>	<del>---</del>
<del>65829-002</del>	<del>0.25/.010 THK 1/4 HD BRASS ALLOY UNS C26000</del>	<del>1.02μ/40μ" GOLD AT CONTACT REMAINDER GOLD FLASH OVER 1.27μ/50μ" NICKEL</del>	<del>---</del>
65829-003	0.25/.010 BRASS ALLOY	.76μ/30μ" Au or GXT AT CONTACT OVER 1.27μ/50μ" NICKEL	NOTE 5,6

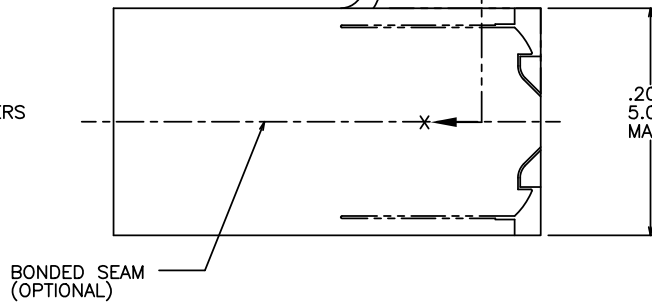

SECTION XX

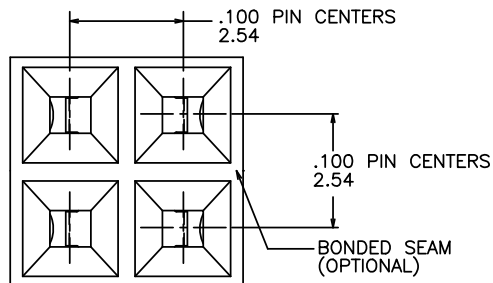

NOTES:

- ① WHITE LINES AS SHOWN FOR POLARIZATION.
- ② HOUSING MAT'L: PLAIN POLYESTER, OPT. PLAIN NORYL, FLAME RETARDANT PER UL-94V-0 COLOR BLACK.
- ③ TERMINAL BODY MAT'L: SEE TABLE
4. SPRING MAT'L: 0.122/.0048 TH'K BE CU ALLOY, UNS C17200. HEAT TREATED PLATING: GOLD FLASH.
5. ADD "LF" SUFFIX AT THE END OF PART NUMBER FOR LEAD FREE OPTION.
- ⑥ THESE PRODUCTS MEET EUROPEAN UNION DIRECTIVES AND OTHER COUNTRY REGULATIONS AS DESCRIBED IN GS-22-008.
7. THE PRODUCT IS NOT INTENDED TO BE EXPOSED TO A MANUFACTURING SOLDER PROCESS.

mat'l. code		surface ISO 1302 ✓	tolerance ISO 406 ISO 1101	projection ①	product family JUMPER
ltr ecn nldr date		tolerances unless otherwise specified		title	
E	ADDED EB	4/9/86	angles	.X±.01/.3	2X2 MINI JUMPER ASS'Y .100 X .100
F	M05-0205	MHT 9/30/05	linear	.XX±.05/.13	
G	M06-0238	MN 06/16/06	0°±2'	.XXX±.0020/.05	dwg no 65829 sheet of 1 size A3
H	M06-0389	AGS 10/4/06	dr	M. HERNANDEZ 9/30/05	
J	EX-N-011384	J.Z 2012-04-24	engr	S. FIERRO 9/30/05	
			chr	S. FIERRO 9/30/05	type Product Customer Drawing
			appd	S. FIERRO 9/30/05	
sheet index	revision	sheet	1		