


© COPYRIGHT 1979 BY AMP INCORPORATED, HARRISBURG, PA. ALL INTERNATIONAL RIGHTS RESERVED. AMP INCORPORATED PRODUCTS COVERED BY U. S. AND FOREIGN PATENTS AND/OR PATENTS PENDING.

P/E	LTR.	DESCRIPTION	DATE	APP.
✓	K	REVISED AF 0771	12/13/84	JTE/84
✓	L	DBS -3 AF-3157	8/22/88	Pat/88
✓	M	ADD -4 PER AF-8059	8/11/92	Inf
	M1	REVISED PER ECO-09-025273	16NOV09	AEG

REVISIONS				
ZONE	LTR	DESCRIPTION	DATE	APPROVED
	A	REVISED A-47	9/6/79	SS
	B	REVISED & RELEASED PER A-4441	1/9/80	SS/RML
	C	ADDED .25 A-47	1/3/80	67
	D	REVISED A-47	3/20/80	JG
	E	REVISED A-47	5/13/80	JG
	F	REVISED A-4711	7-780	RUDY
	G	REVISED PER A-4746	8/15/80	SS/67
	H	REVISED PER A-5687	10/13/82	SS/REF
	J	ADDED -3 PER TTI-82/96	11/8/82	SS/67

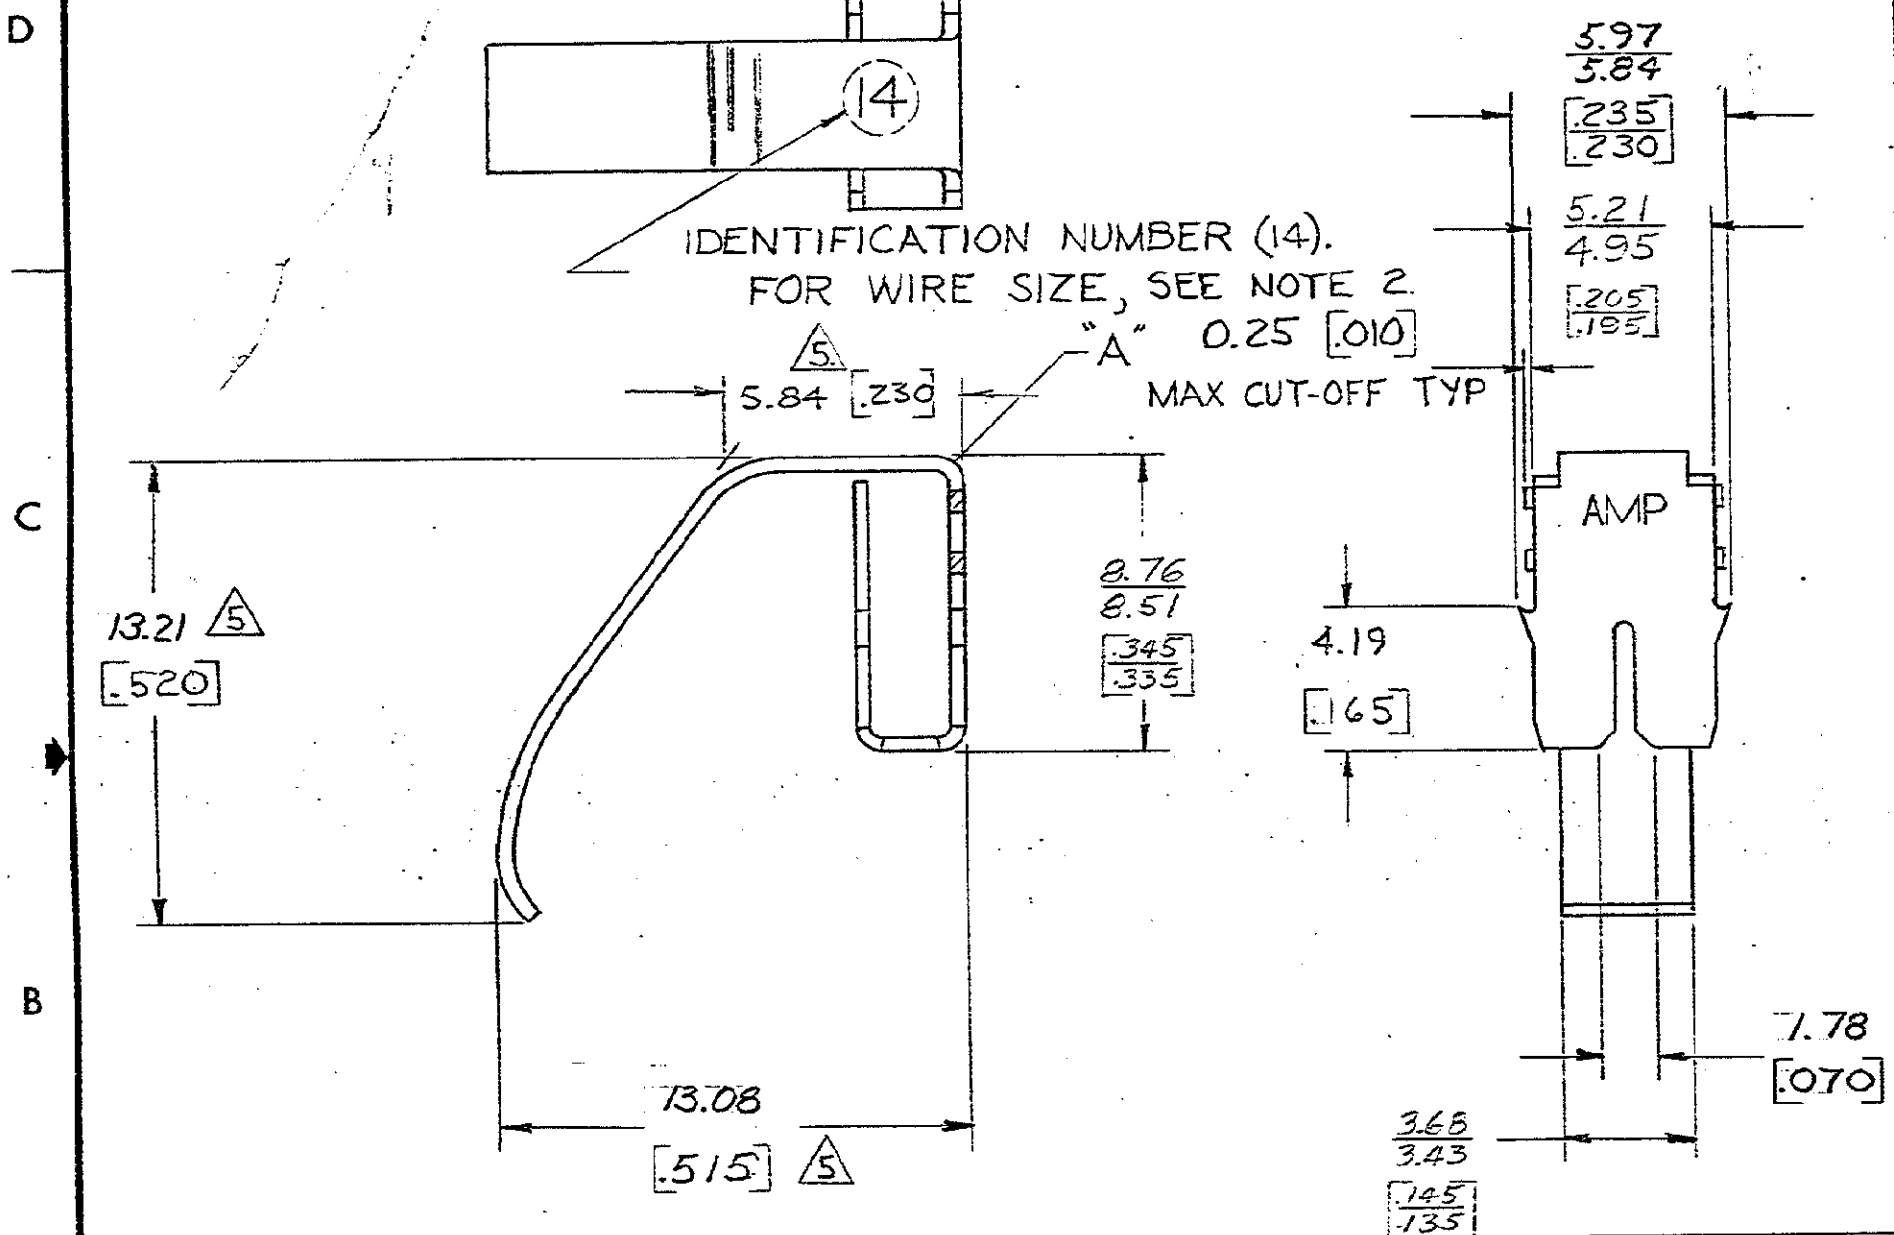

2. WIRE RANGE: 0.2 - 0.6 mm<sup>2</sup> [#24-20]  
7 STRANDS OR SOLID,  
INSULATION DIA: 1.78 [070] MAX

3. FOR CAVITY DETAILS SEE APPLICATION SPECIFICATION 114-2044  
4. RECOMMENDED BATTERY HOLDER SPECIFICATIONS:  
A) "9" VOLT BATTERY - CP78-7721  
B) "C" SIZE BATTERY - CP78-7926  
C) "D" SIZE BATTERY - CP78-7875

5. THESE DIMENSIONS APPLY WHEN CORNER "A" IS FIXTURED AT 90°

6. SUPPLIED LOOSE PIECE  
7. DIM'S IN BRACKETS ARE IN INCHES.

8. OBSOLETE PARTS: OBSOLETE CIS STREAMLINING PER D.RENAUD/D.SINISI

FINISH	PART NO
OBSOLETE 0.0010 MIN BRIGHT NICKEL	<del>62879-4</del>
OBSOLETE BRIGHT TIN OVER NICKEL	<del>62879-3</del>
OBSOLETE TIN	<del>62879-2</del>
NONE	62879-1

**METRIC**

UNLESS OTHERWISE SPECIFIED DIMENSIONS ARE IN INCHES MM TOLERANCES ON: DECIMALS ±0.38 [015] ANGLES ±

MATERIAL 0.30 [012] BRASS  
FINISH SEE TABLE

CONTRACT NO  
DR Steve Schaffhausen  
CHK GY etia 7/3/79  
APPD A.W. Carroll 7/3/79  
APPD G. W. ... 7/3/79  
DSGN APPD  
OTHER APPD

**AMP** AMP INCORPORATED Harrisburg, Pa.

NAME UNIVERSAL BATTERY CONTACT

SIZE B CODE IDENT NO 00779 DRAWING NO 62879

SCALE SHEET