

Customer Information Sheet

DRAWING No.: D01-99332XX

SHEET 2 OF 2


IF IN DOUBT - ASK

©

NOT TO SCALE

THIRD ANGLE PROJECTION

ALL DIMENSIONS IN mm

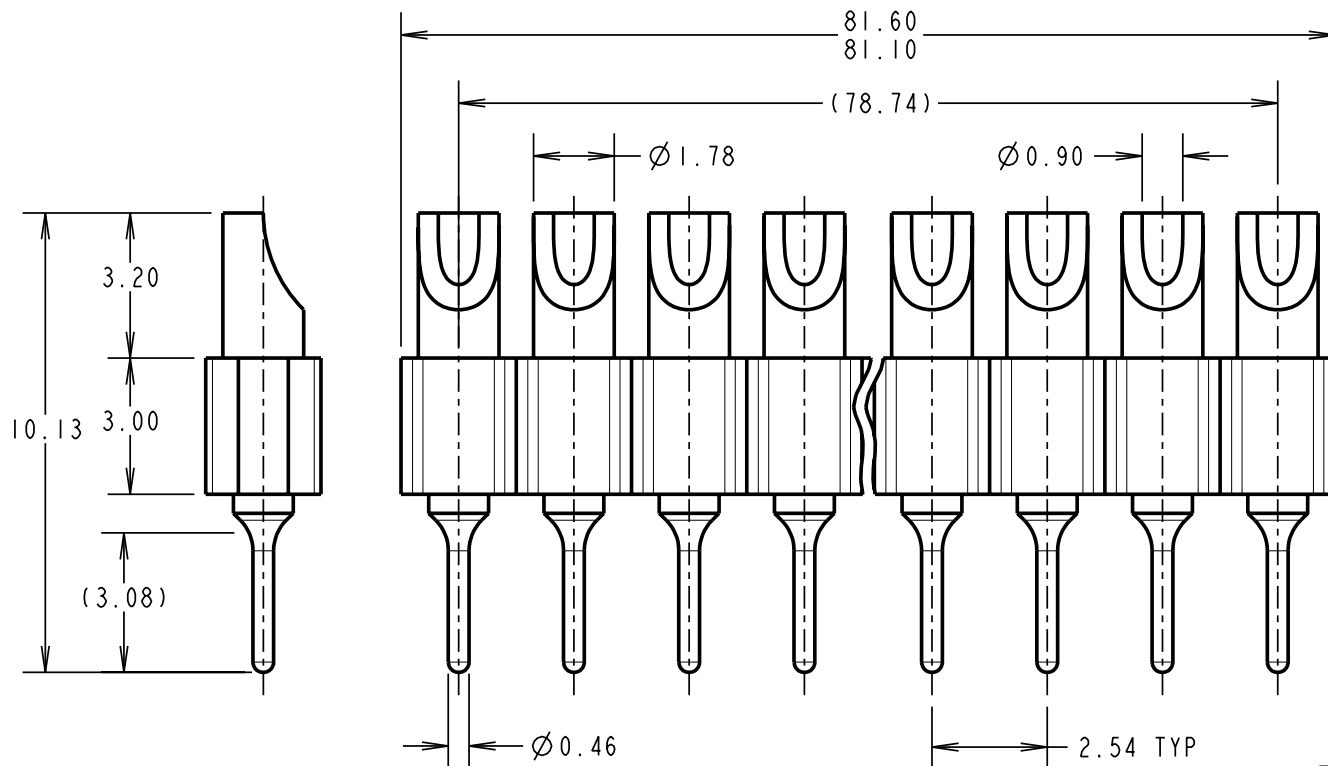

SPECIFICATION:

MATERIAL:

~~MOULDING:~~

~~01 = 30% G/F POLYESTER, UL94V-0, BLACK~~

MOULDING:

46 = 30% G/F POLYAMIDE 46, UL94V-0, BLACK

CONTACT = BRASS

FINISH:

CONTACT = 3.5-5.0µ 100% TIN OVER 2µ NICKEL

ELECTRICAL:

CURRENT RATING AT 25°C = 1.5A

CURRENT RATING AT 85°C = 0.25A

CONTACT RESISTANCE:

INITIAL = 15 mΩ MAX

AFTER CONDITIONING = 23 mΩ MAX

INSULATION RESISTANCE:

INITIAL = 1,000 MΩ MIN

AFTER CONDITIONING = 100 MΩ MIN

MECHANICAL:

DURABILITY = 1,000 OPERATIONS

ENVIRONMENTAL:

TEMPERATURE RANGE = -55°C TO +125°C

PACKING: BAG

FOR COMPLETE SPECIFICATION, SEE COMPONENT SPECIFICATION C004XX (LATEST ISSUE)

NOTES:

- RECOMMENDED PCB HOLE SIZE = Ø0.80mm MIN.

ORDER CODE:
D01-99332XX

No. OF CONTACTS
 (32)

FINISH
~~01 = 100% TIN~~
 46 = 100% TIN (ROHS COMPLIANT)

OBSELETE

RA	7	14.01.09	10257
NAME	ISS.	DATE	C/NOTE
APPROVED:		R. ADDE	
CHECKED:		M.G.PLESTED	
DRAWN:		W. J. BOURNE	
CUSTOMER REF.:			
ASSEMBLY DRG.:			

HARWIN

HARWIN USA
 TEL: 603 893 5376
 FAX: 603 893 5396
 mis@harwin.com

HARWIN Europe (UK)
 TEL: 023 9231 4545
 FAX: 023 9231 4590
 mis@harwin.co.uk

HARWIN Asia
 TEL: +65 6 779 4909
 FAX: +65 6 779 3868
 mis@harwin.com.sg

THIS DRAWING AND ANY INFORMATION OR DESCRIPTIVE MATTER SET OUT HEREON ARE CONFIDENTIAL AND COPYRIGHT PROPERTY OF THE HARWIN GROUP AND MUST NOT BE DISCLOSED, LOANED, COPIED OR USED FOR MANUFACTURING, TENDERING OR FOR ANY OTHER PURPOSE WITHOUT THEIR WRITTEN PERMISSION.

TOLERANCES
 X. = ±1mm
 X.X = ±0.25mm
 X.XX = ±0.10mm
 X.XXX = ±0.01mm
 ANGLES = ±5°
 UNLESS STATED

MATERIAL:
 SEE ABOVE
FINISH: SEE ABOVE
S/AREA: mm²

TITLE:
 I.C. SIL SOLDER CUP HEADER
DRAWING NUMBER:
D01-99332XX
 SHT 2 OF 2