

Customer Information Sheet

DRAWING No.: D3083-XX

SHEET 2 OF 2


IF IN DOUBT - ASK

©

NOT TO SCALE

THIRD ANGLE PROJECTION

ALL DIMENSIONS IN mm

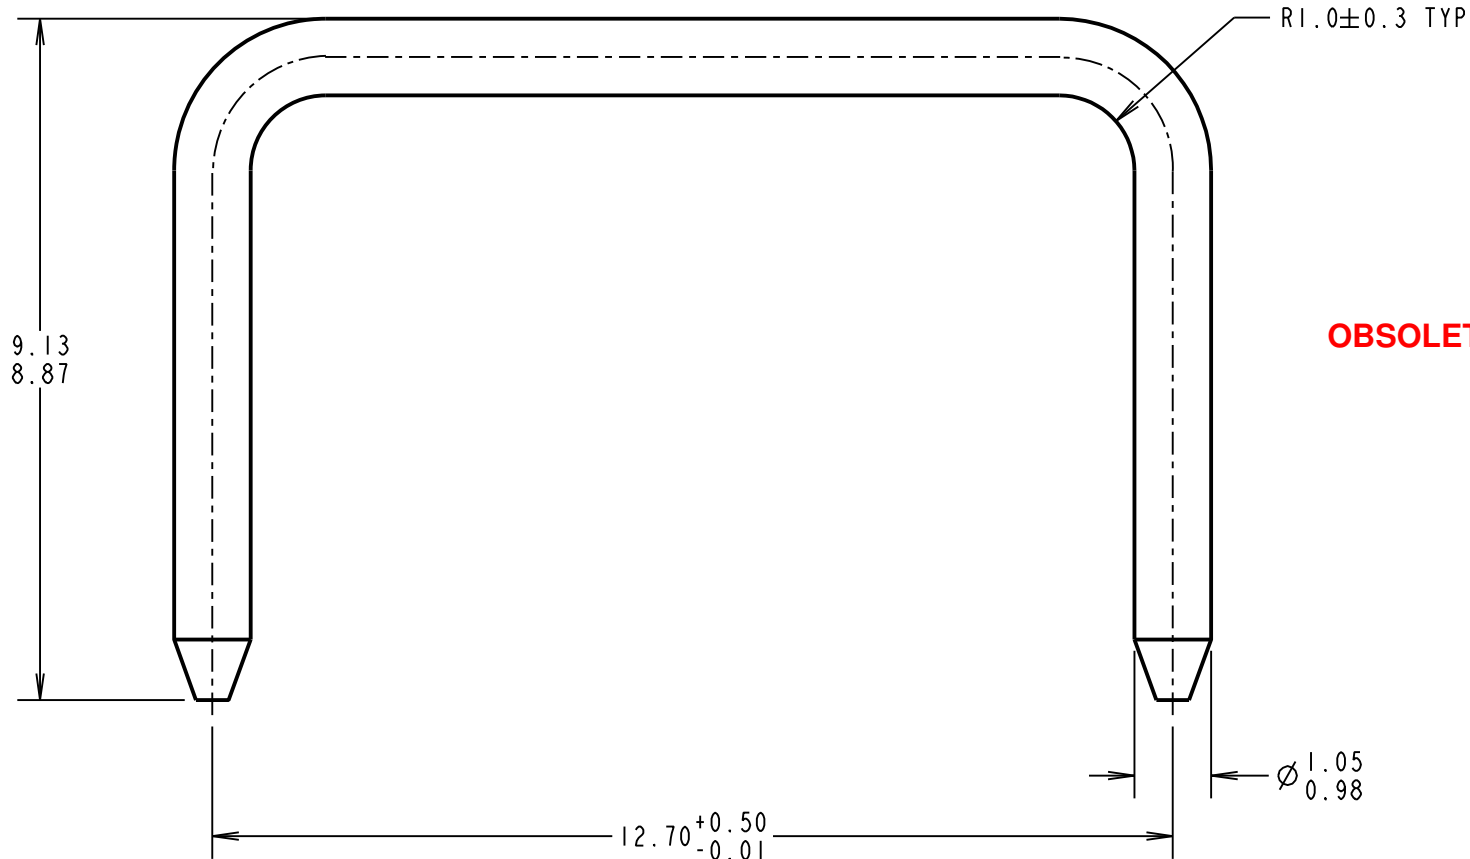

OBSOLETE

ORDER CODE:
D3083-XX

FINISH: _____

~~01 = 100% MATTE TIN~~
~~05 = GOLD FLASH~~
 46 = 100% BRIGHT TIN

SB	10	18.12.12	11891
NAME	ISS.	DATE	C/NOTE
APPROVED:		S.BENNETT	
CHECKED:		S.FLOWER	
DRAWN:		C. HANSEN	
CUSTOMER REF.:			
ASSEMBLY DRG:			
D3089-XX			

PART No.	FINISH
D3083-01	2.54µ 100% MATTE TIN OVER 0.76µ NICKEL UNDERCOAT
D3083-05	GOLD FLASH OVER 0.76µ NICKEL UNDERCOAT
D3083-46	2.54µ 100% BRIGHT TIN OVER 0.76µ NICKEL UNDERCOAT

HARWIN

www.harwin.com
 technical@harwin.com

THIS DRAWING AND ANY INFORMATION OR DESCRIPTIVE MATTER SET OUT HEREON ARE CONFIDENTIAL AND COPYRIGHT PROPERTY OF THE HARWIN GROUP AND MUST NOT BE DISCLOSED, LOANED, COPIED OR USED FOR MANUFACTURING, TENDERING OR FOR ANY OTHER PURPOSE WITHOUT THEIR WRITTEN PERMISSION.

TOLERANCES
 X. = ±1mm
 X.X = ±0.25mm
 X.XX = ±0.10mm
 X.XXX = ±0.01mm
 ANGLES = ±5°
 UNLESS STATED

MATERIAL:
 BRASS C2600

FINISH: SEE ABOVE

S/AREA: mm²

TITLE:
 1mm SHORTING LINK

DRAWING NUMBER:
D3083-XX

SHT
 2
 OF
 2