DWG. NO. 1-1437507-0 | REV.

DO NOT SCALE PRINT

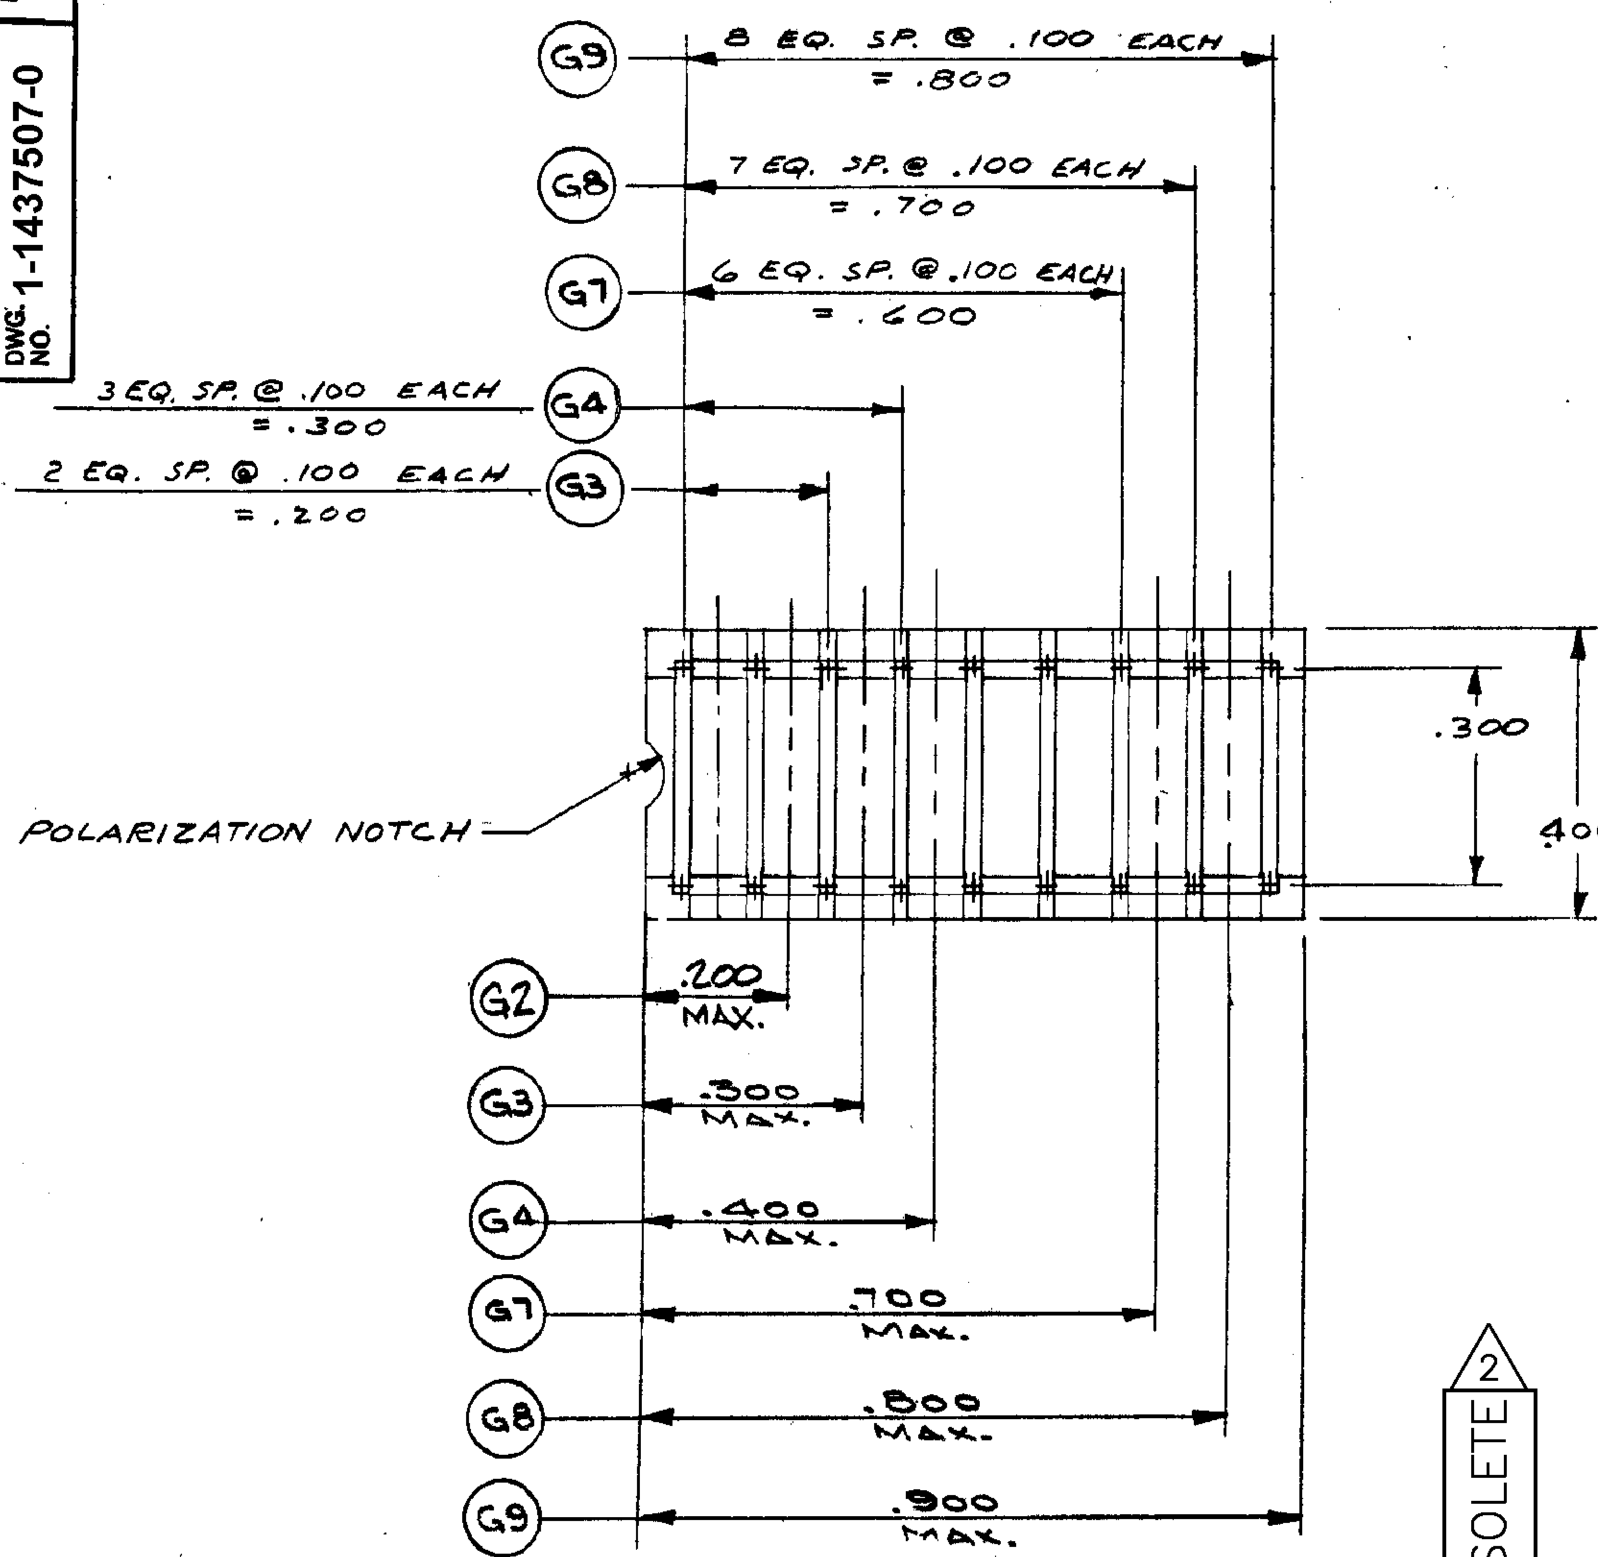

NOTES:

1. MATERIAL AND FINISH:
   INSULATOR ____ THERMOPLASTIC POLYESTER UL RATED 90 V-O; COLOR-BLACK
   (G) CONTACT ____ PHOSPHOR BRONZE, GOLD OVER NICKEL PLATE
   (GT) CONTACT ____ PHOSPHOR BRONZE, TIN PLATE.

2 (in triangle) OBSOLETE PARTS: OBSOLETE CIS STREAMLINING PER D.RENAUD/D.SINISI

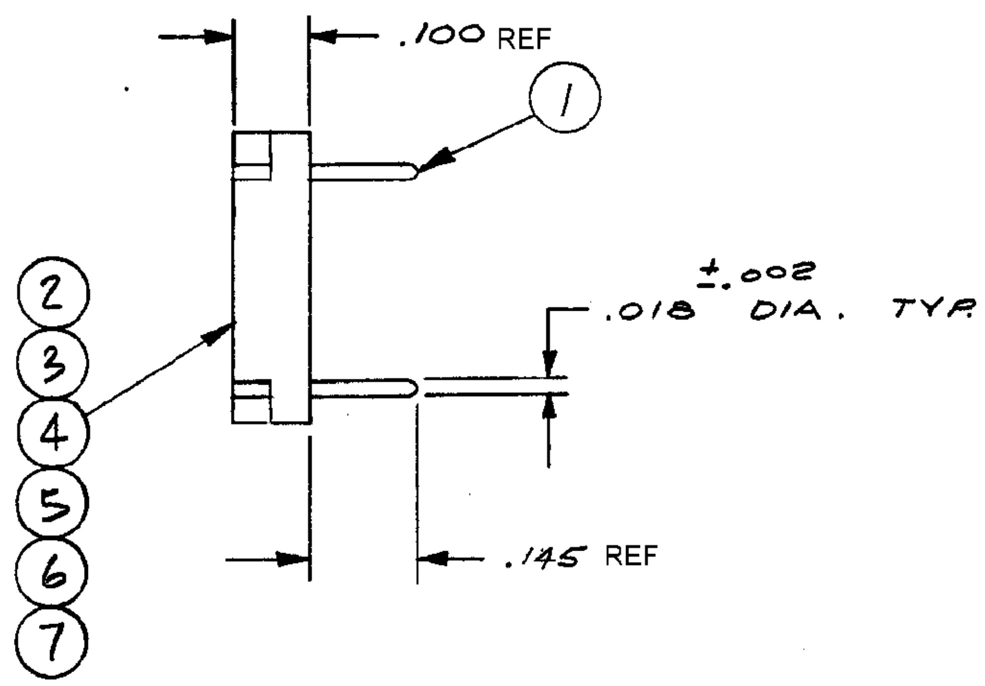

PART NO.S

N/A	~~1-1437507-2~~ OBSOLETE (2)	1-1437507-1	N/A	~~3-1437506-2~~ SUP BY 2-1437507-1	2-1437507-0	~~1-1437507-8~~ OBSOLETE (2)	1-1437507-6	~~1-1437507-4~~ OBSOLETE	1-1437507-0	2-1437507-1	1-1437507-9	1-1437507-7	1-1437507-5	1-1437507-3	DESCRIPTION	ITEM NO.
9	8	7													SHORTING PIN	1
			2	9	8	7	4	3							SHORTING PIN	1
			1						1						INSULATOR	7
1				1						1					INSULATOR	6
	1				1						1				INSULATOR	5
		1				1						1			INSULATOR	4
							1						1		INSULATOR	3
								1						1	INSULATOR	2
									2	9	8	7	4	3	SHORTING PIN	1
G25	G24	G23	G2T	G9T	G8T	G7T	G4T	G3T	G2	G9	G8	G7	G4	G3		
QUANTITY									QUANTITY							

LTR	変更 (REVISION RECORD)	DR	CHK	DATE
A1	REVISED PER ECO-11-005140	RK	HMR	31MAR11

UNLESS OTHERWISE SPECIFIED DIMENSIONS ARE IN INCHES
TOLERANCES ON
FRACTIONS — DECIMALS REF ANGLES --

MATERIAL: —
FINISH: —

ORIGINAL DATE OF DRAWING: 4-4-73	
DRAWN: RJS	DATE: 4-4-74
CHECKED: R.J.H.	DATE: 4-5-74
APPROVED: R.J.H.	DATE: 4-5-74
CODE IDENT. NO. 91506	DWG. SIZE C
NEXT ASSY.	

TE Connectivity

TITLE: PROGRAMMING PLUG

DWG. NO. 1-1437507-0 | REV. A1

SCALE: 4X1 | SHEET 1 OF 1

CUSTOMER DWG.